

ADDENDUM NO. 2 – APRIL 19th, 2021

The following changes, additions and deletions to the Drawings and Specifications shall be considered part of the Contract Documents called **2101 CUMBERLAND SCHOOL DEPARTMENT - HIGH SCHOOL ENTRANCE WING: RENOVATIONS TO ADMIN AREA**, dated 24 March 2021. This Addendum consists of **02** pages.

MODIFICATIONS TO THE PROJECT MANUAL:

ITEM NO. 1: Section 09680 – Carpeting: - 2.01 Materials: Delete paragraph E

MODIFICATIONS TO THE DRAWINGS:

ITEM NO.1: See attached SKA-1 for additional scope of work with regard to existing 1x1 tile ceiling above existing 2x4 SAT

RESPONSES TO BIDDER’S QUESTIONS:

1. It appears there is no work taking place in the area where asbestos is present. Please clarify.
Response to Question 1: Correct. Further study has verified that areas of ceiling, finishes and roofing impacted by the scope of this project do not indicate the presence of hazardous material.
2. Section 09680 – Carpeting - 2.01 Materials paragraph A. specifies J&J style: Well Versed Modular 7072 24” x 24” carpet tile While right below it 2.01 Materials paragraph E Carpet Materials. specifies a 26 oz. 12’ wide broadloom What is the carpet to be, carpet tile or broadloom?
Response to Question 2: Carpet tile are paragraph A. See item #1 above.
3. Item #20 on addendum #1 dated 4/12/2021.does not mentioned exactly what BMS manufacturer is existing in the building, so please identify that on your next email
Response to Question 3: ENE Systems is the controls company.

END OF ADDENDUM NO. 2



TORRADO
ARCHITECTS

30 GERRARD STREET
FLOOR 10
TORONTO, ONTARIO
M5S 1A7

CUMBERLAND
HIGH SCHOOL
ENTRANCE WING


2600 Mendon Road
Cumberland, Rhode Island

REFLECTED
CEILING
PLAN

REVISION
REFLECTED CEILING PLAN

DATE: 4/16/2021
DRAWN: C.D.
SCALE: AS NOTED
CHECKED: R.S.

SKA-1
SHEET

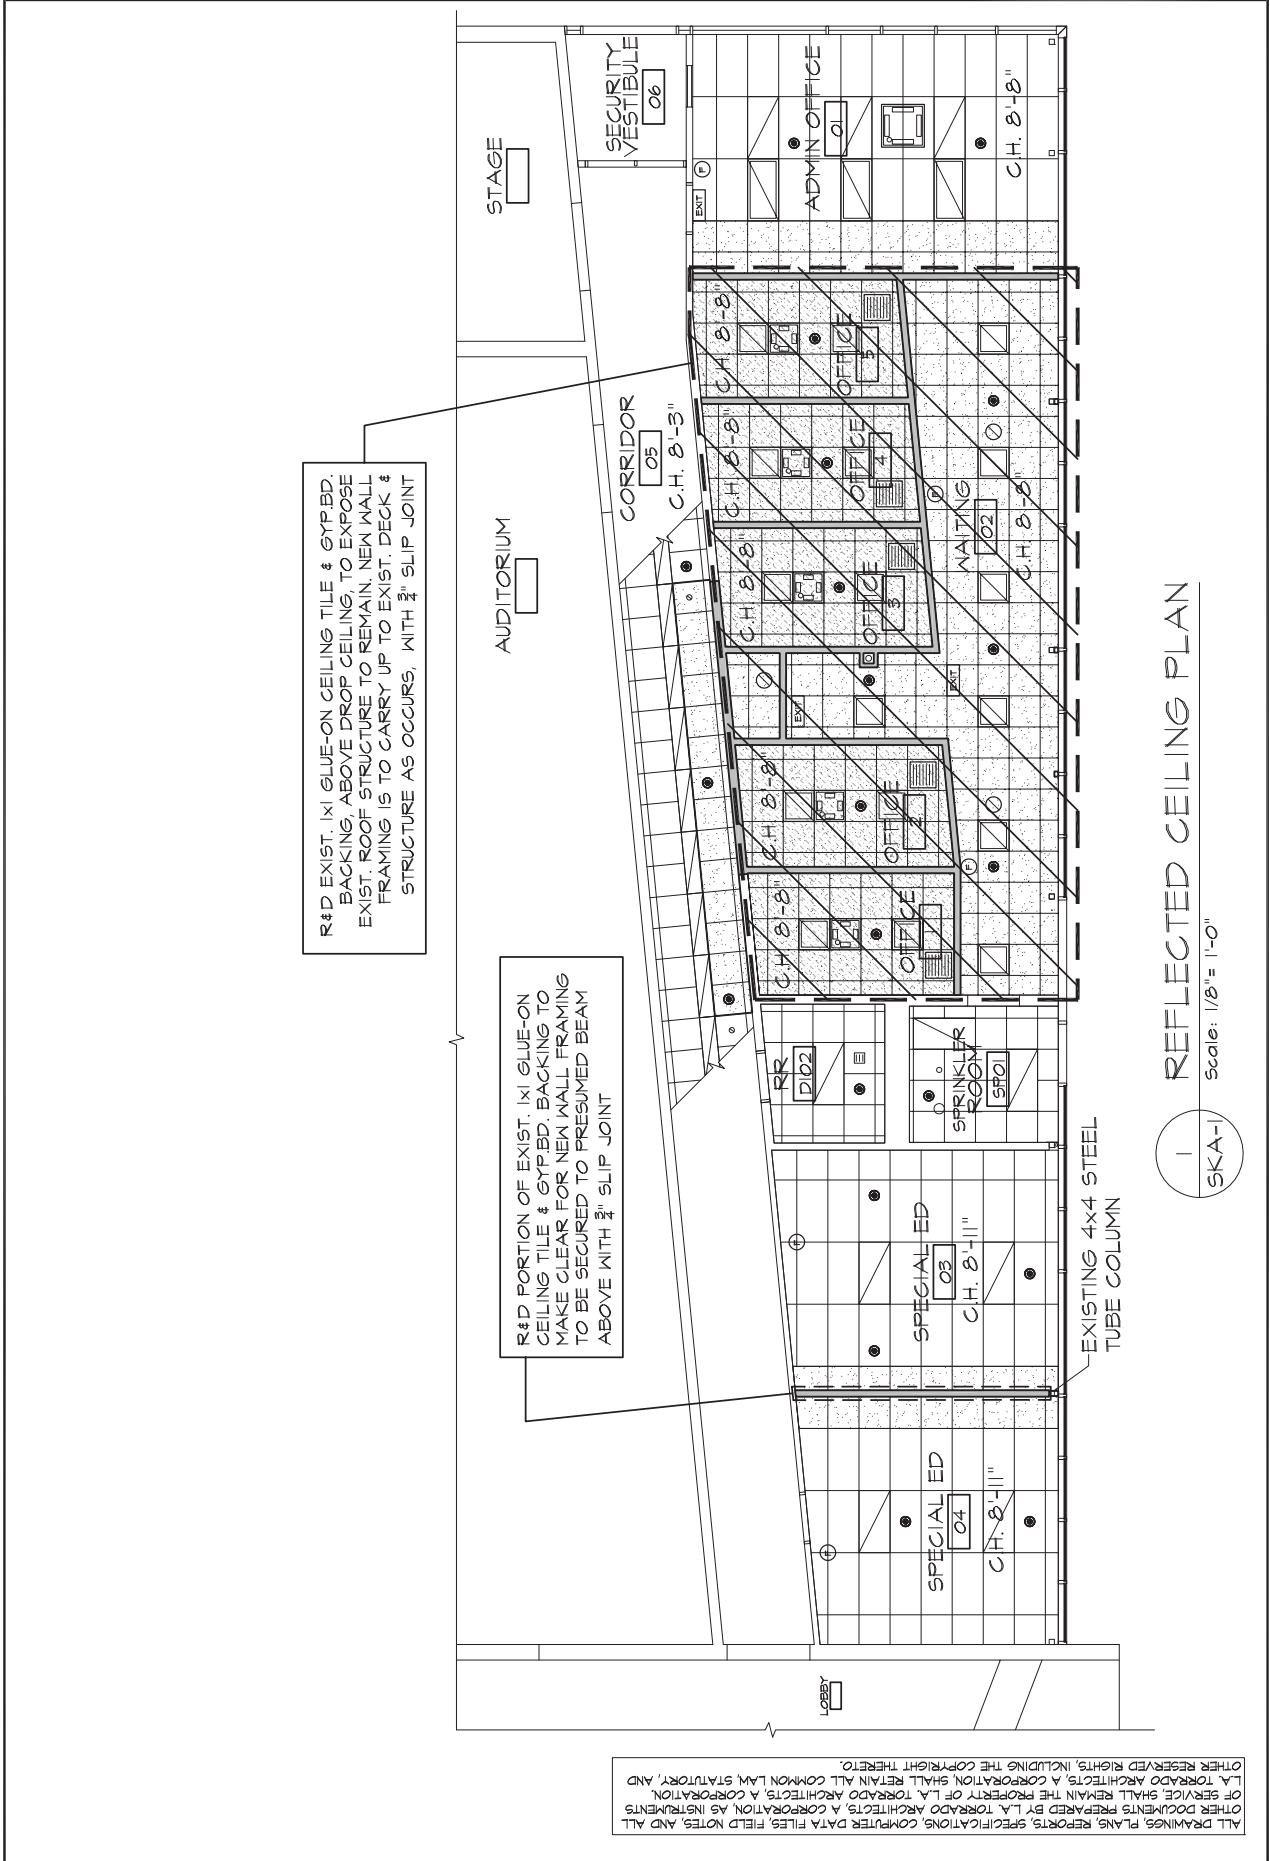

1 REFLECTED CEILING PLAN
Scale: 1/8" = 1'-0"

SKA-1

ALL DRAWINGS, PLANS, REPORTS, SPECIFICATIONS, COMPUTER DATA FILES, FIELD NOTES, AND ALL OTHER RESERVED RIGHTS, INCLUDING THE COPYRIGHT THEREIN, ARE RESERVED BY TORRADO ARCHITECTS, A CORPORATION, AND SHALL REMAIN THE PROPERTY OF TORRADO ARCHITECTS, A CORPORATION, AND TORRADO ARCHITECTS, A CORPORATION, SHALL RETAIN ALL COMMON LAW STATUTORY, AND OTHER RESERVED RIGHTS, INCLUDING THE COPYRIGHT THEREIN.